



REV.	NO.	DESCRIPTION	DATE	DATE	DATE
1	1	ISSUED	2/04	2/04	
		Designed	OK	2/04	
		Drawn	SD	2/04	
		Checked			
		Approved			

**S**  
SHARPTON & LEWIS

**S & L CONSULTANTS LTD**  
SURVEYORS - ENGINEERS - PLANNERS  
111 Cameron Road, Tauranga  
New Zealand  
P.O. Box 231 PH(07)577-6069  
Fax(07)577-6065  
Email: slinfo@xtra.co.nz

TITLE  
**MAYFIELD**  
**STAGE 7**


**DRAINAGE PLAN**

Copyright in this drawing is reserved.  
ORIGINAL SCALES  
1:500 (A2) 02'04


DATE  
02'04

DRAWING NO  
**17249**


REVISIONS  
17

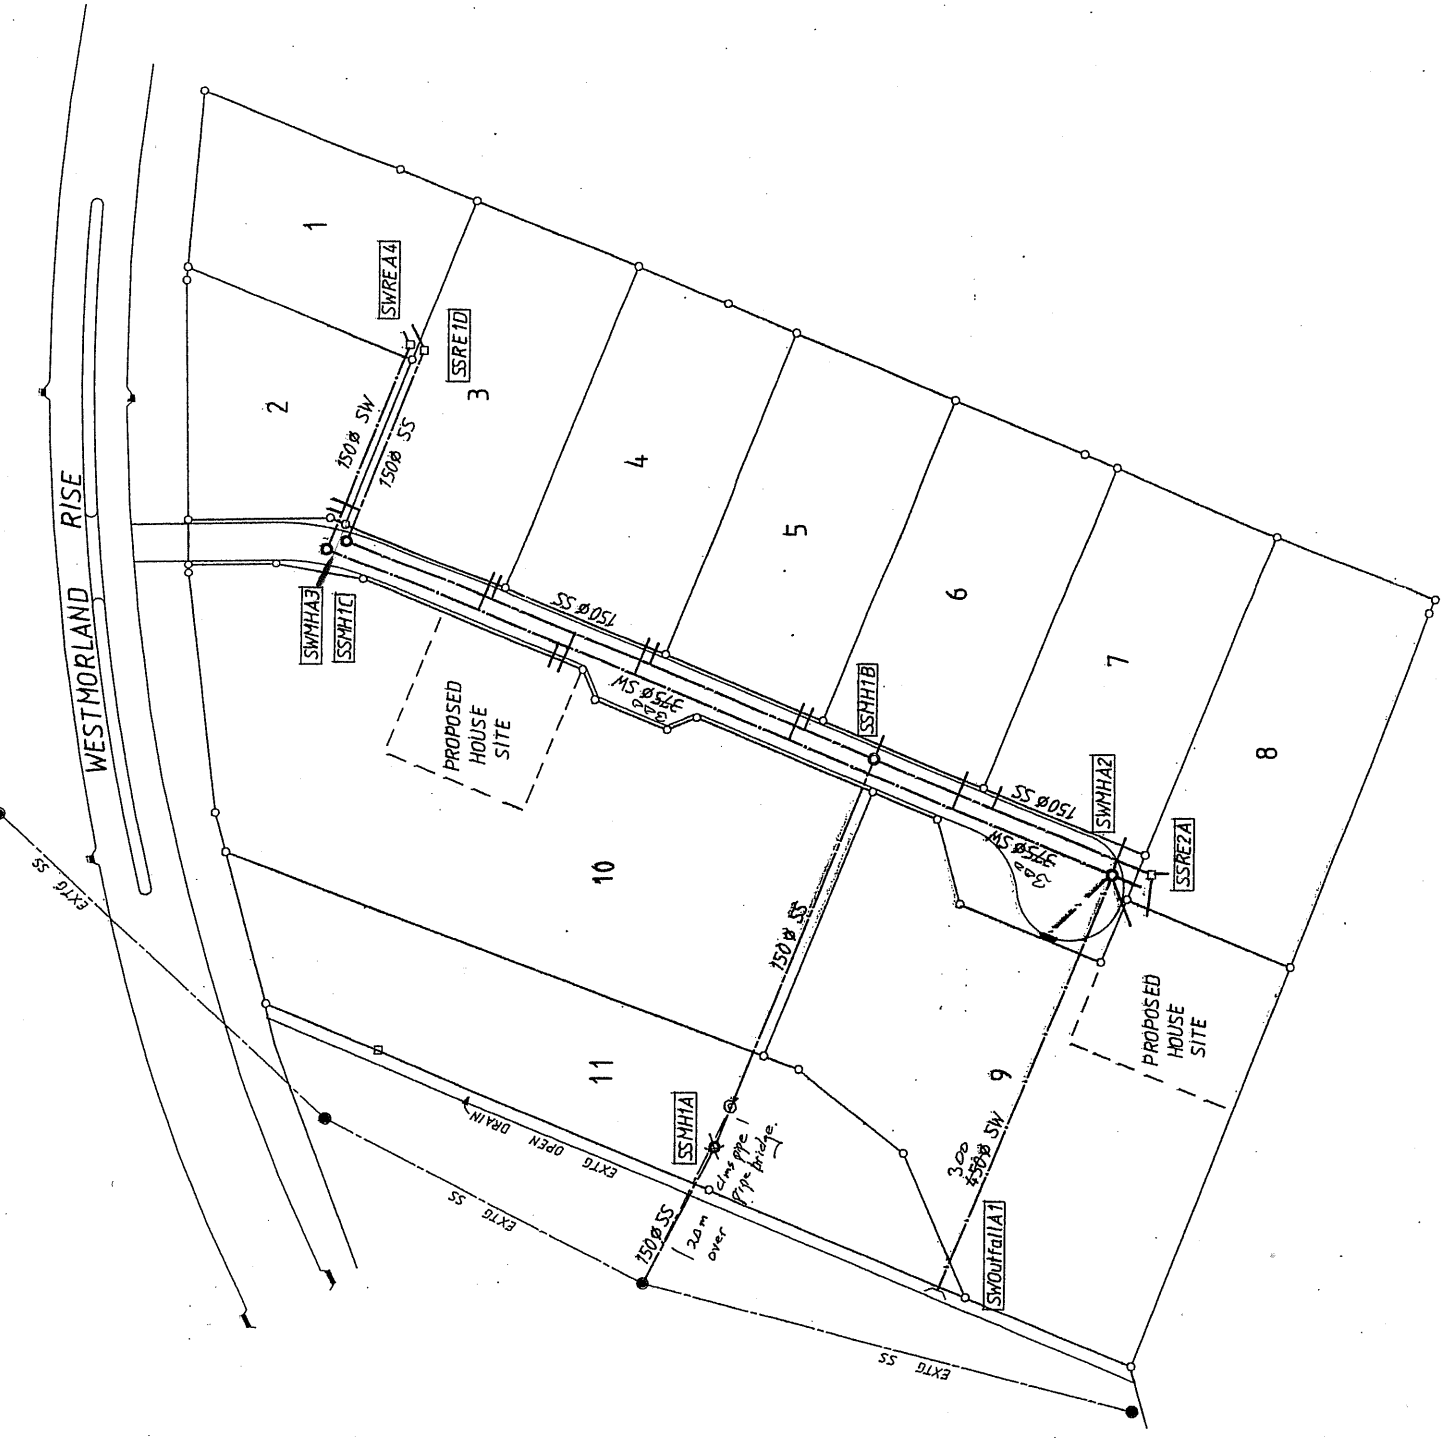

SCALE 1:500

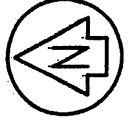

**NOTE**  
 All house connections to be 20mm  $\phi$  terminated with a 20mm  $\phi$  lobby back-flow preventer & water meter all contained within a service connection box terminating 300mm from the front lot boundary.

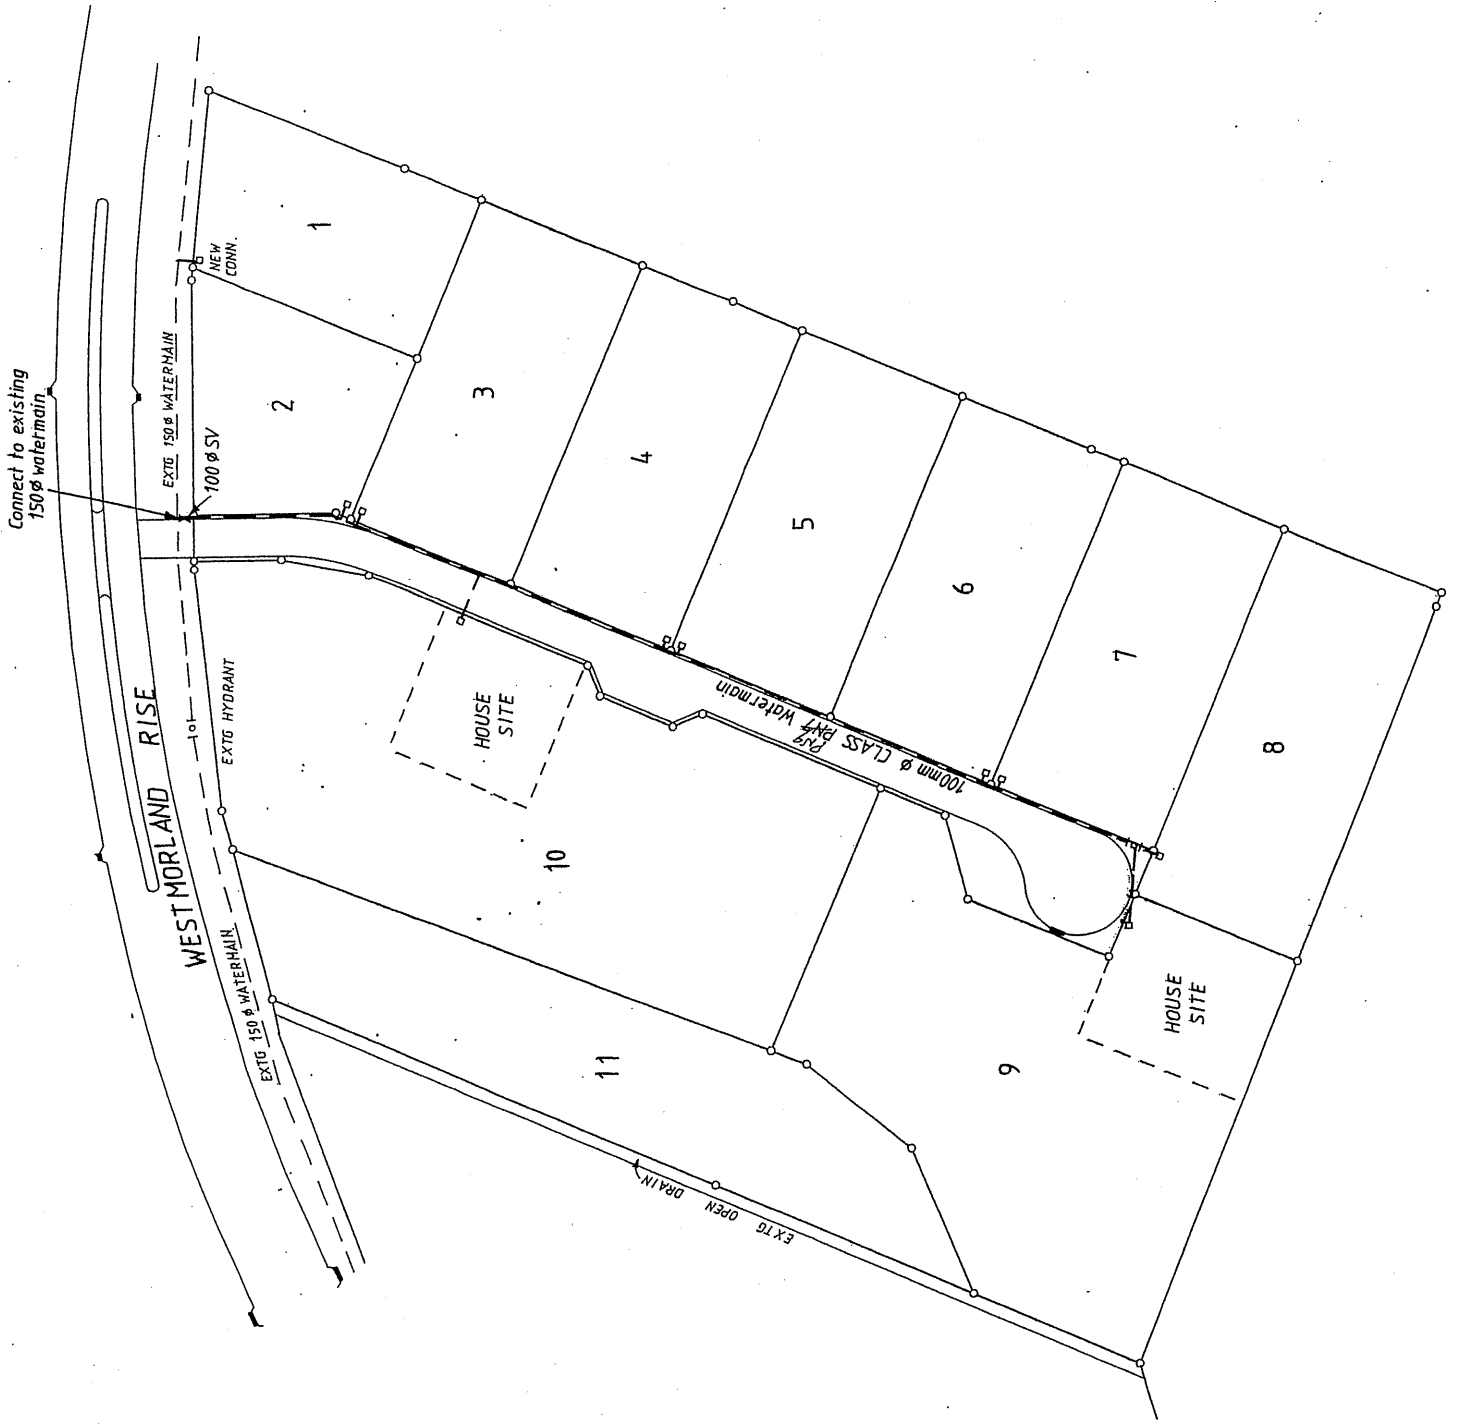

SP. No.	Description	DATE
1		

NAME	DATE	SIGNED
SK	2/04	
SB	2/04	

REFERENCES




**S & L CONSULTANTS LTD**  
 SURVEYORS - ENGINEERS - PLANNERS  
 111 Cameron Road, Tauranga  
 New Zealand  
 P.O. Box 231 Ph: (07) 577-6069  
 Fax: (07) 577-6065  
 Email: sl@slr.co.nz

TITLE  
**MAYFIELD**  
 STAGE 7



**WATER RETICULATION**  
 PLAN

Copyright in this drawing is reserved  
 ORIGINAL SCALES DATE  
 1:500 (A2) 02/04

DRAWING NO  
**17249**

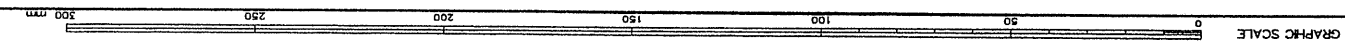

SCALE 1:500

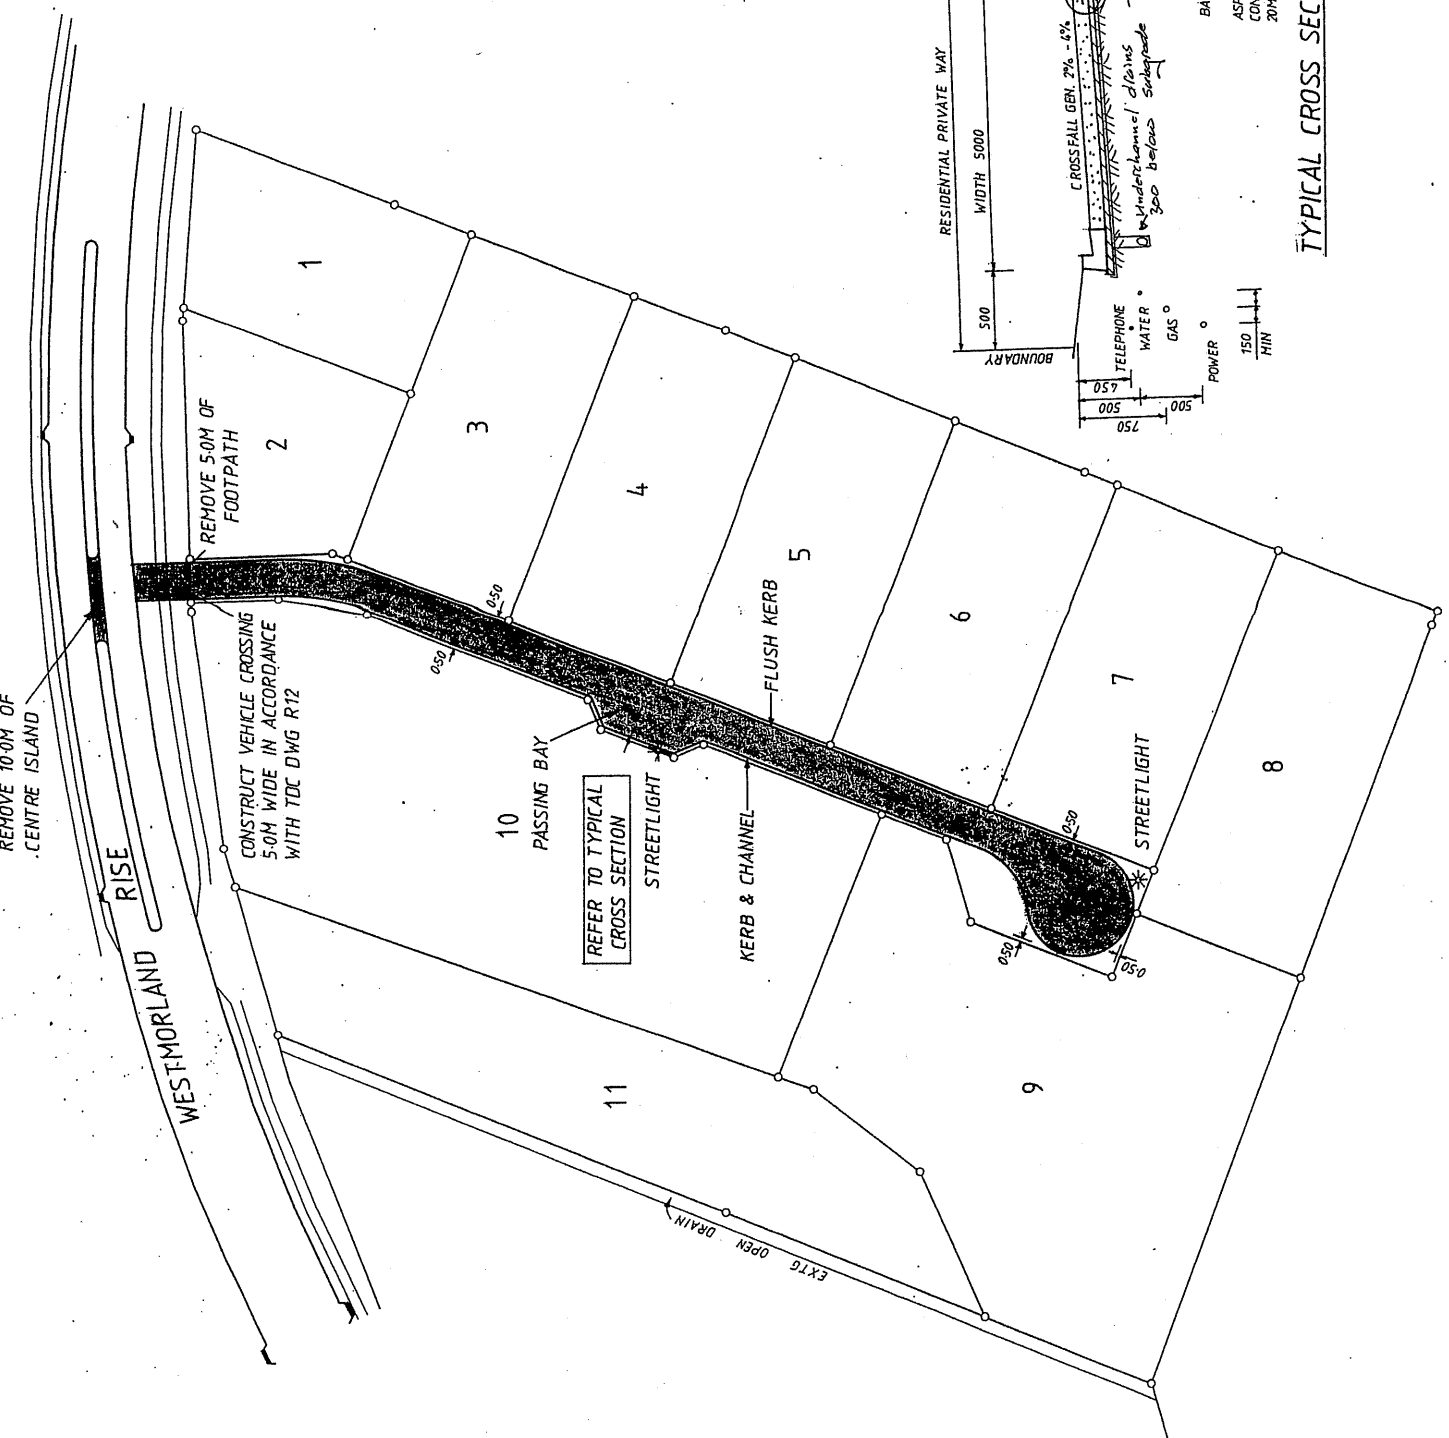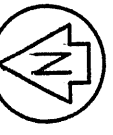

Sl. No.	Name	Description	Date	Scored
1	SK	Surveyed	2/04	
	SD	Drawn	2/04	
		Checked		
		Approved		

REFERENCES

**S & L CONSULTANTS LTD**  
 SURVEYORS - DRAUGHTSMEN - PLANNERS  
 111 Cameron Road, Tauranga  
 New Zealand  
 P.O. Box 231 Ph: (07) 577-6069  
 Fax: (07) 577-6065  
 Email: sl@slc.co.nz

TITLE  
**MAYFIELD**  
**STAGE 7**

PLAN OF  
**PRIVATE WAY**

DATE  
 02'04

ORIGINAL SCALES  
 1:500 (A2)

DRAWING No  
**17249**

Revision: 1/1

**TYPICAL CROSS SECTION**

SCALE 1:500

