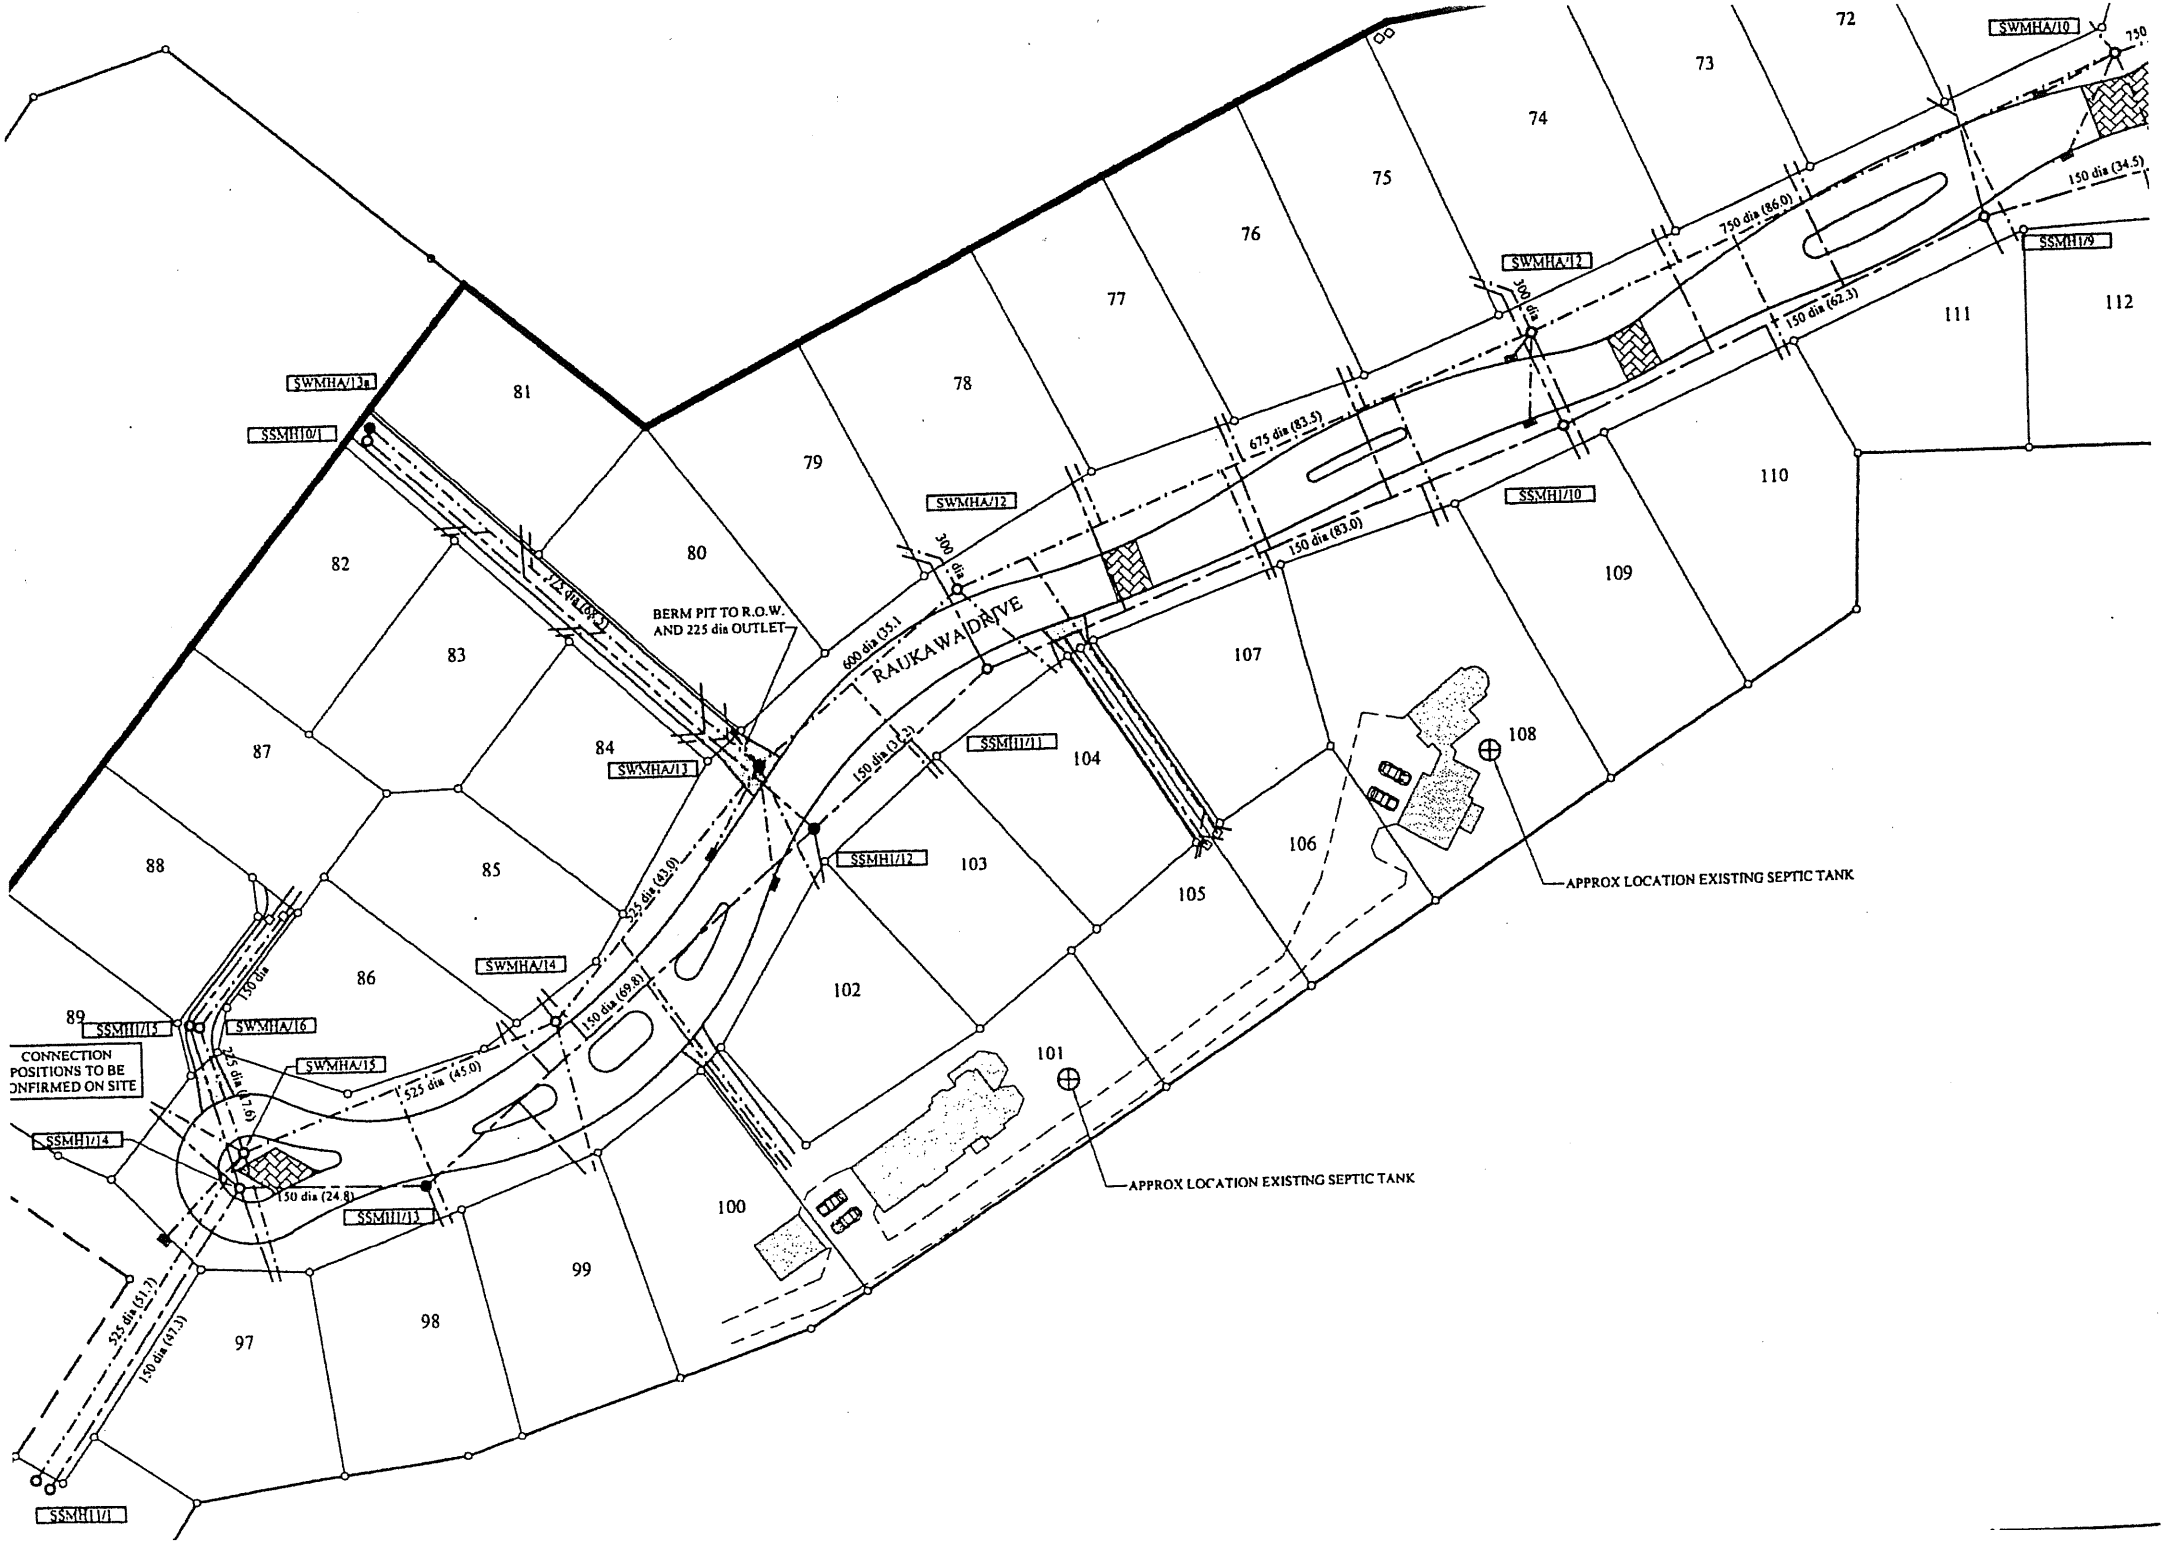
RAUKAWA DRIVE
BERM PIT TO R.O.W. AND 225 dia OUTLET
CONNECTION POSITIONS TO BE CONFIRMED ON SITE
APPROX LOCATION EXISTING SEPTIC TANK
APPROX LOCATION EXISTING SEPTIC TANK
SWMHA/10
SWMHA/12
SWMHA/12a
SWMHA/13
SWMHA/14
SWMHA/15
SWMHA/16
SSMH1/9
SSMH1/10
SSMH1/11
SSMH1/12
SSMH1/13
SSMH1/14
SSMH1/15
SSMH10/1
SSMH11/1
750 dia (86.0)
150 dia (34.5)
675 dia (83.5)
150 dia (62.3)
150 dia (83.0)
300 dia
600 dia (35.1)
150 dia (31.2)
525 dia (63.0)
150 dia (69.8)
525 dia (45.0)
150 dia (24.8)
525 dia (51.7)
150 dia (47.3)
150 dia
72
73
74
75
76
77
78
79
80
81
82
83
84
85
86
87
88
89
97
98
99
100
101
102
103
104
105
106
107
108
109
110
111
112

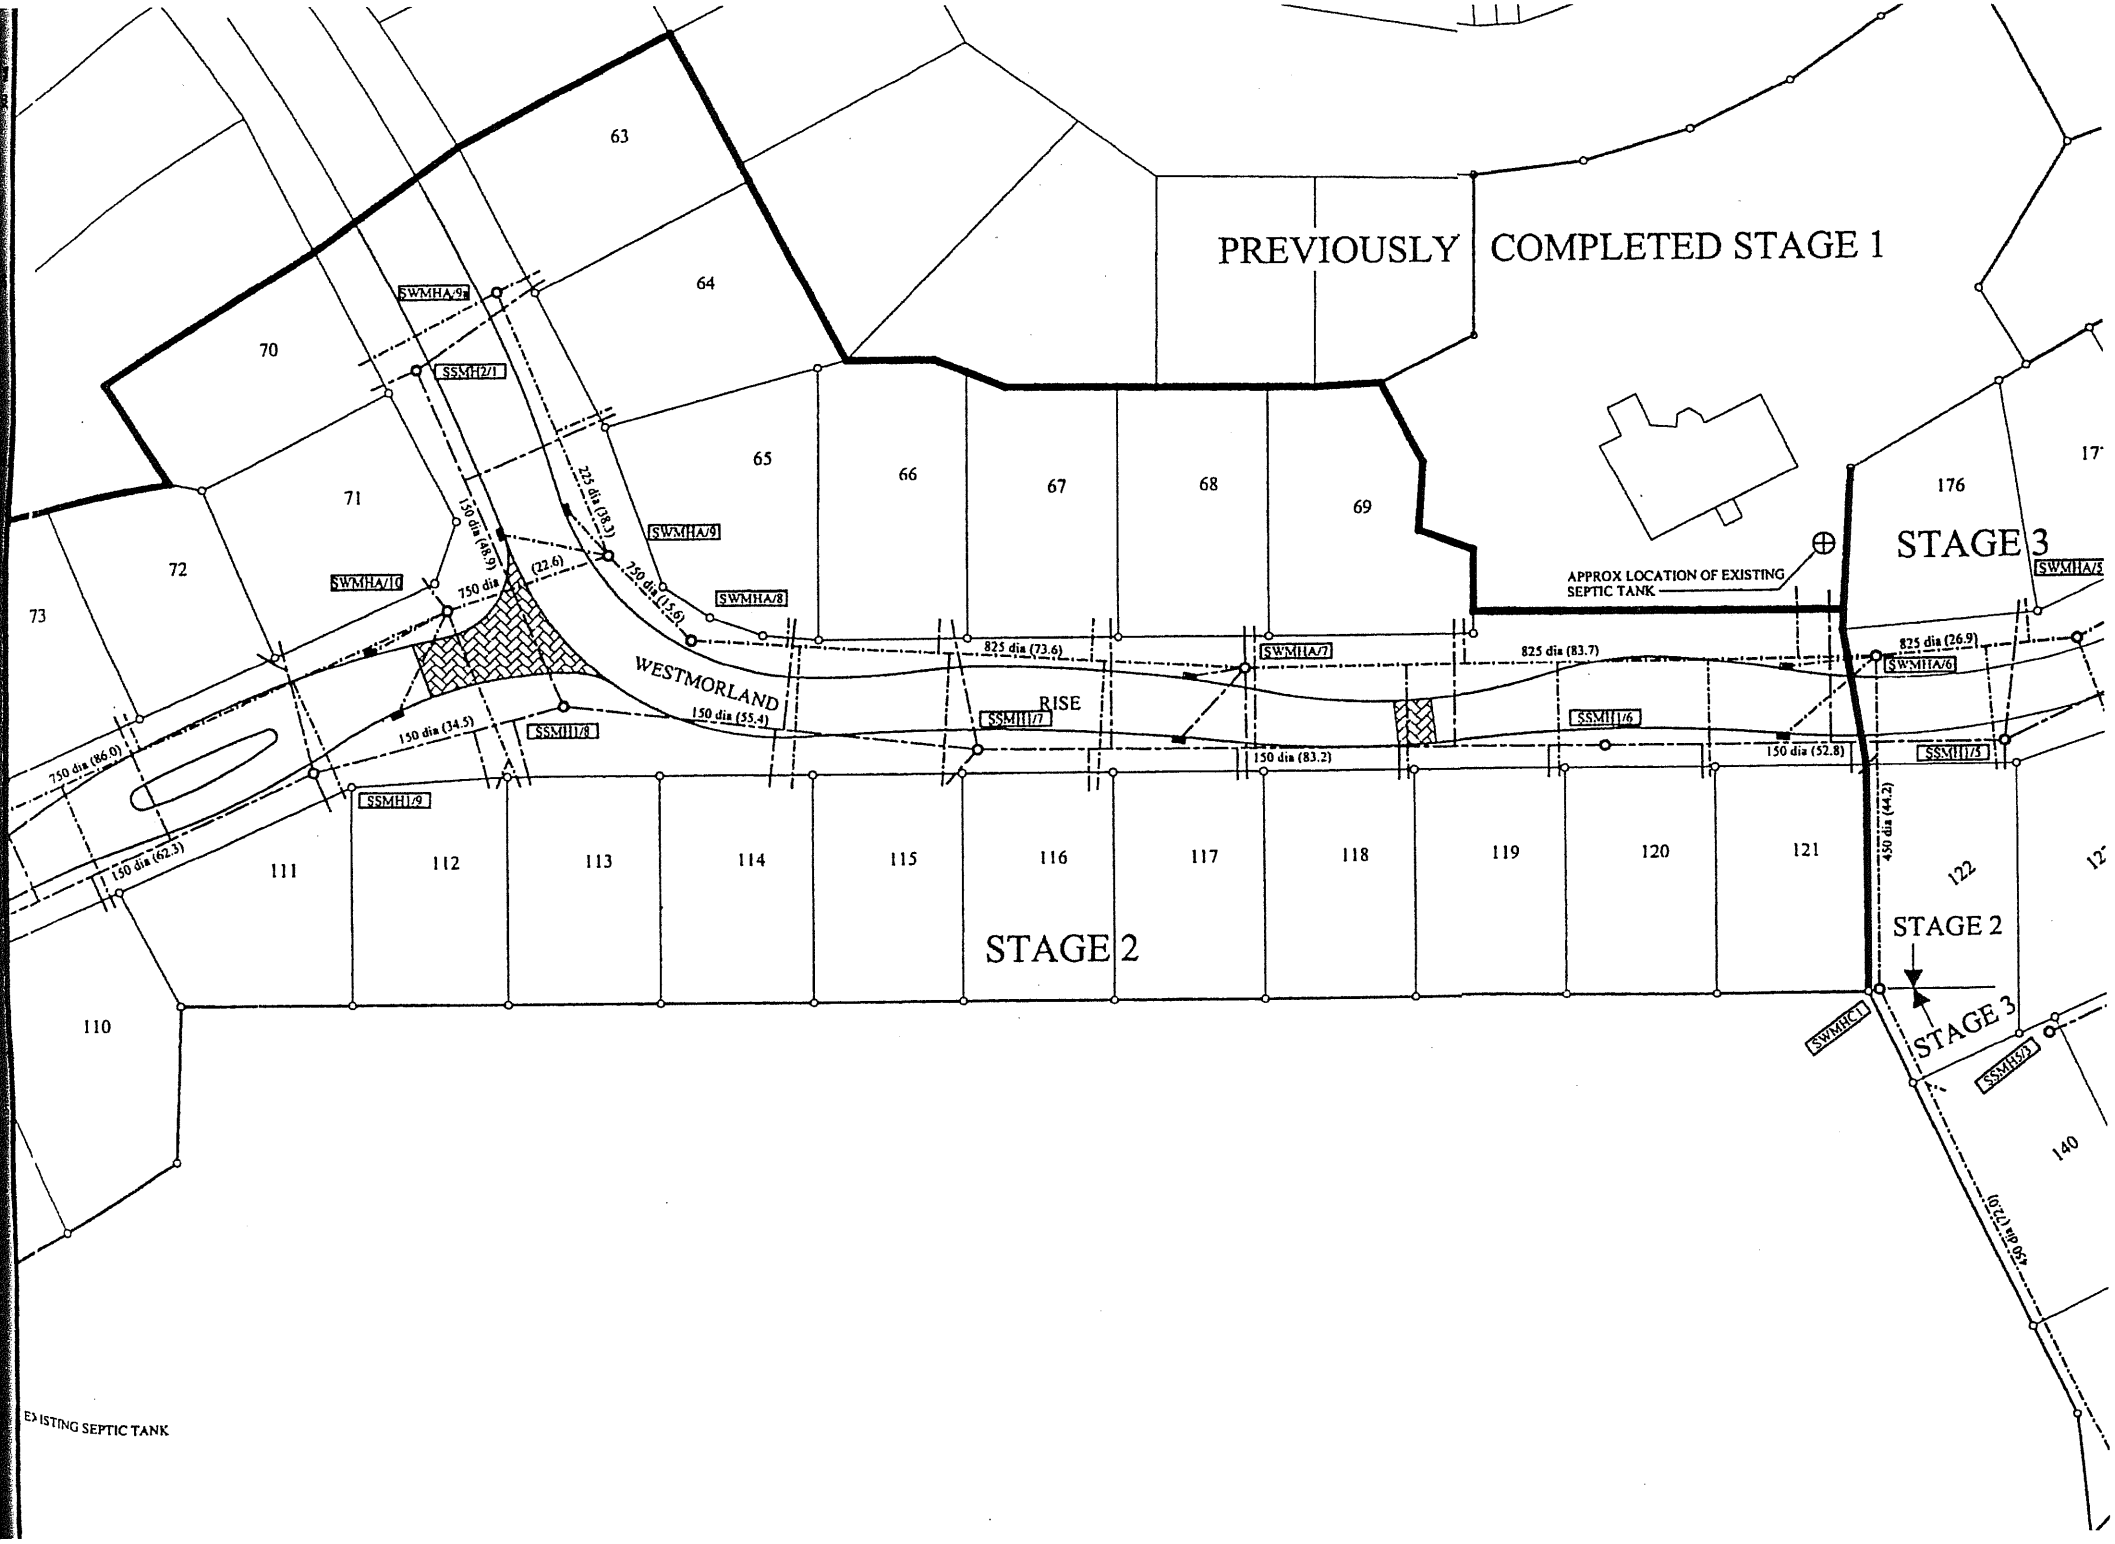
PREVIOUSLY COMPLETED STAGE 1
STAGE 2
STAGE 3
STAGE 2
STAGE 3
WESTMORLAND RISE
APPROX LOCATION OF EXISTING SEPTIC TANK
EXISTING SEPTIC TANK
63
64
65
66
67
68
69
70
71
72
73
110
111
112
113
114
115
116
117
118
119
120
121
122
140
176
SWMHA/9a
SSMH2/1
SWMHA/9
SWMHA/10
SWMHA/8
SWMHA/7
SWMHA/6
SWMHA/5
SSMH1/9
SSMH1/8
SSMH1/7
SSMH1/6
SSMH1/5
SWMHC1
SSMH5/3
225 dia (18.3)
150 dia (46.9)
750 dia
(22.6)
150 dia (15.6)
825 dia (73.6)
825 dia (83.7)
825 dia (26.9)
150 dia (55.4)
150 dia (34.5)
750 dia (86.0)
150 dia (62.3)
150 dia (83.2)
150 dia (52.8)
450 dia (44.2)
450 dia (72.0)